

# Meeting Minutes 019



State Center Community College District- West Fresno Campus

SIM-PBK Project Number: 18-14

Date and Time	09/14/2018 at 1:00pm
Meeting Subject	Student Services
Meeting Location	Student Services Conference Room
Meeting Facilitator	Alan Stilts/Raleigh Sullivan
Attachments:	Markups

## Attendees:

George Cummings	<a href="mailto:George.cummings@scccd.edu">George.cummings@scccd.edu</a>
Becky Barabe	<a href="mailto:becky.barabe@fresnocitycollee.edu">becky.barabe@fresnocitycollee.edu</a>
Lataria Hall	Student Services
Sean Henderson	Student Services
Pam Tibbet	Student Services
Virginia Beamer	Student Services
Penny Sandlin	Student Services
Monica Criado Cuevas	Student Services
Mikki Johnson	Student Services
Emilee Slater	Student Services
Donna Cooper	Student Services
Tammy Maddox	Student Services
Stephanie Powers-Puahi	Student Services
Christine Miktarian	Student Services
Alan Stilts	<a href="mailto:Alan.stilts@pbk.com">Alan.stilts@pbk.com</a>
John Smith	<a href="mailto:jsmith@sim-pbk.com">jsmith@sim-pbk.com</a>
Raleigh Sullivan	<a href="mailto:rsullivan@sim-pbk.com">rsullivan@sim-pbk.com</a>

## Distribution:

Attendees listed with e-mail, Kiesha Oliver, Brian Speece, Cliff Whittingstall, Scott Adams

Submitted By: Raleigh Sullivan

---

## **Items Discussed**

The group discussed the student administration area, library, and main lobby areas. Comments are per the attached markups.


See attached markups.

**END OF MINUTES**







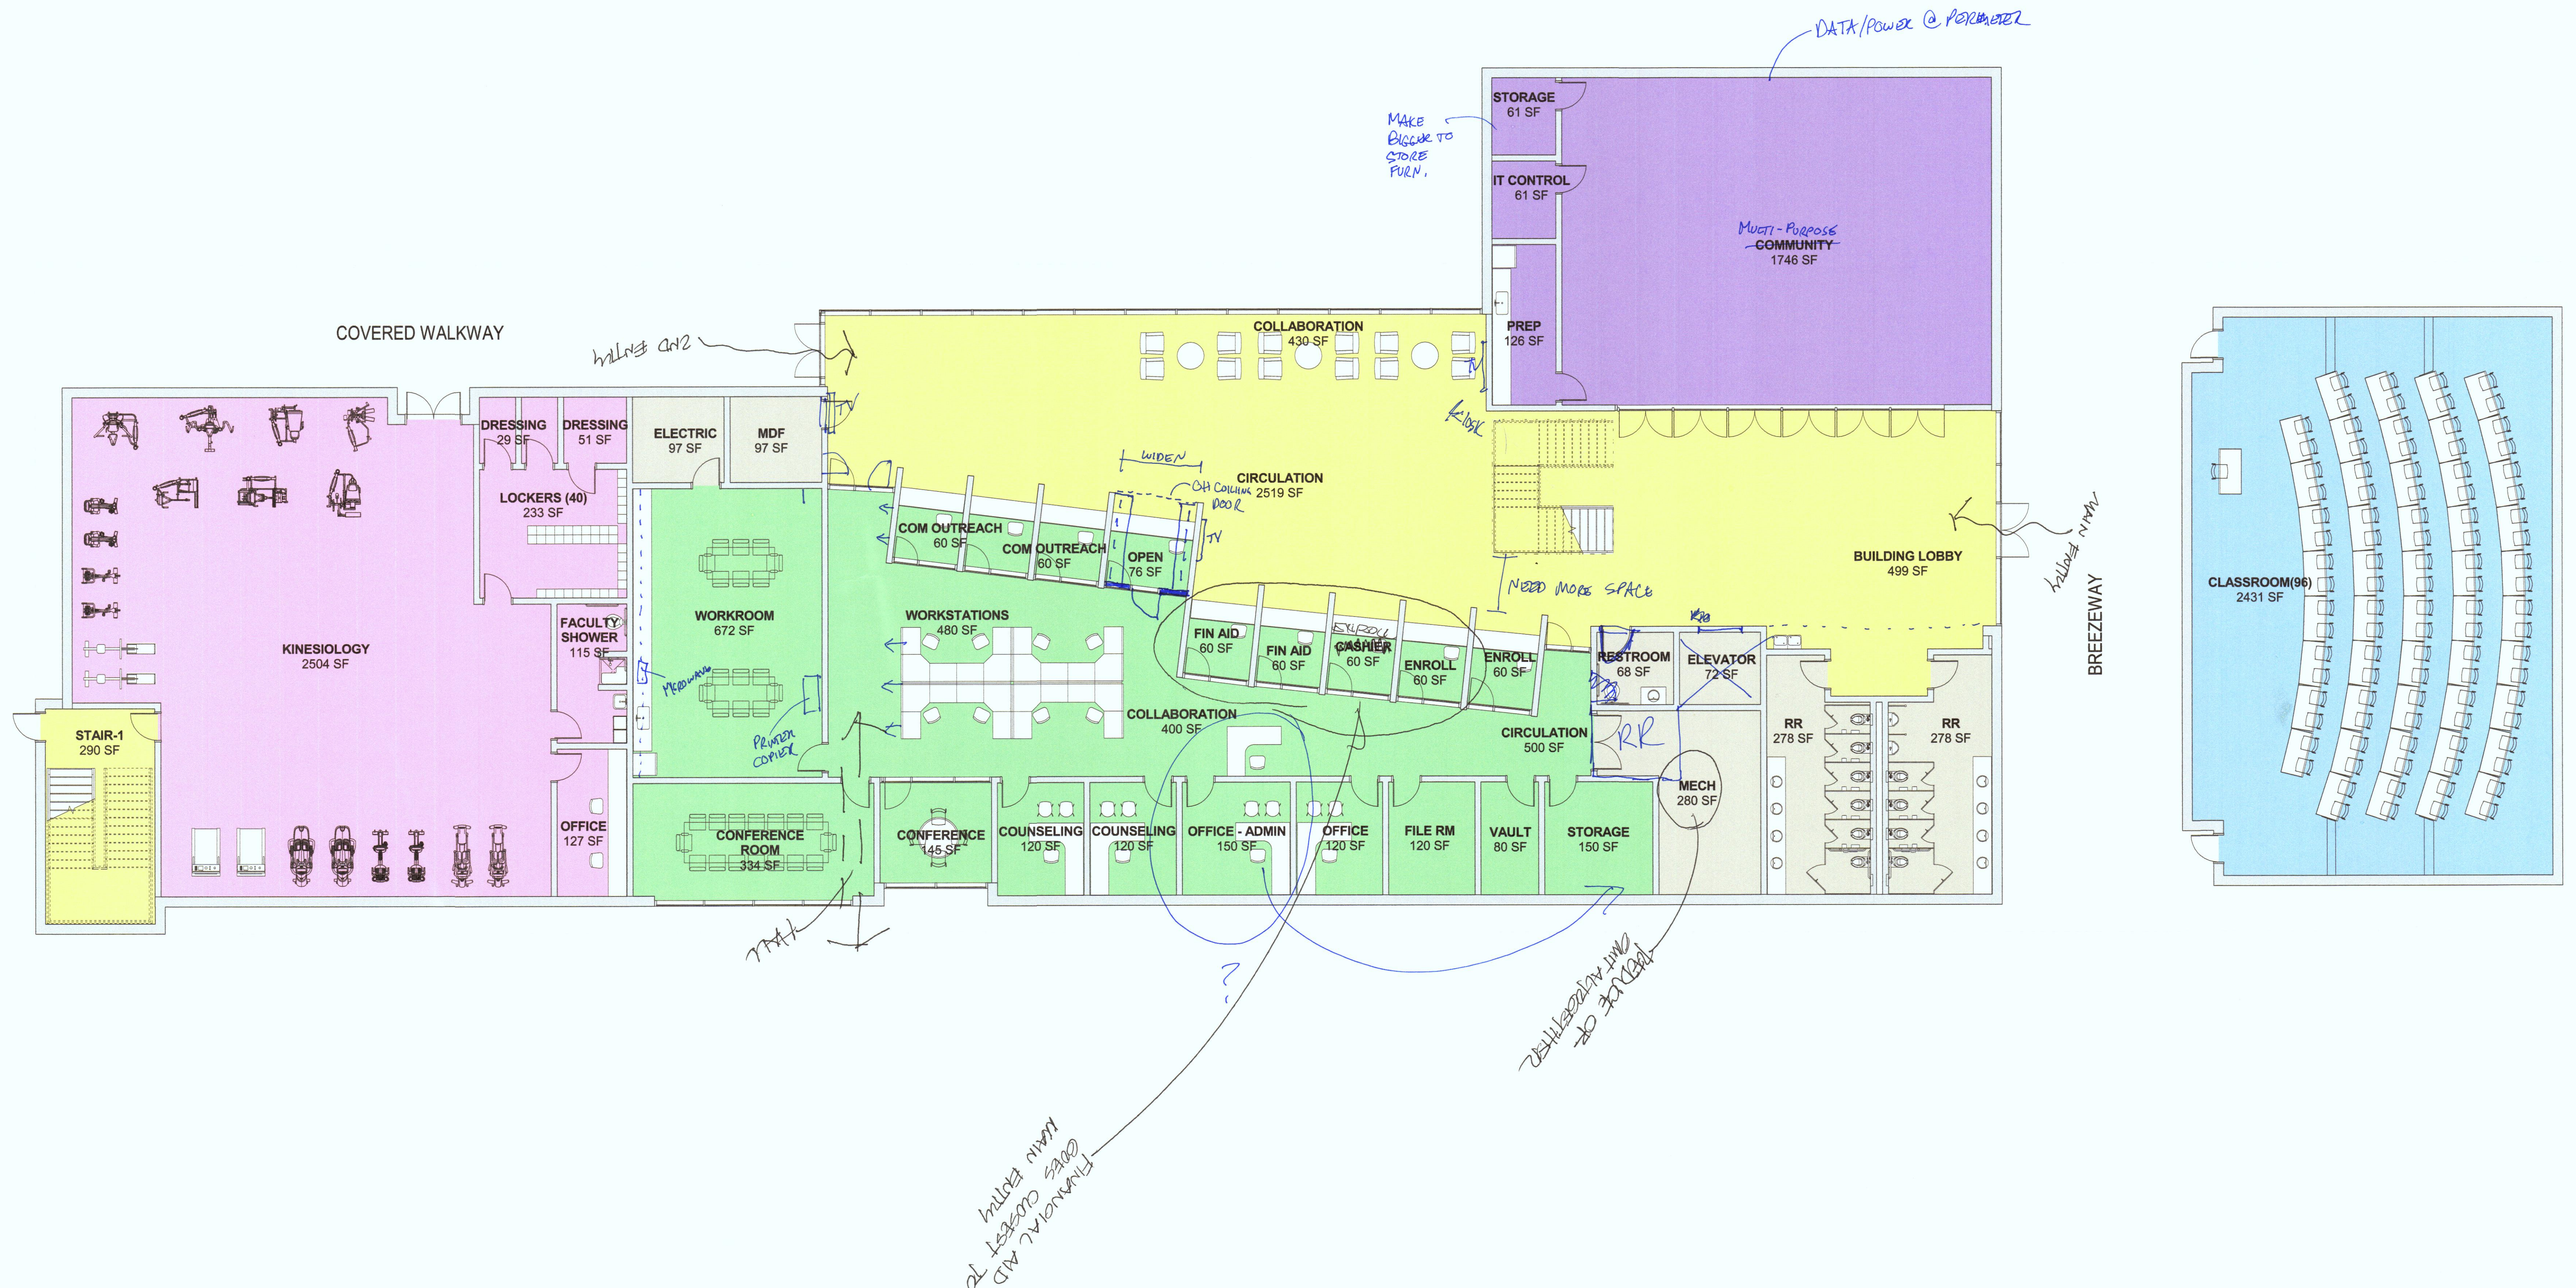

**FIRST FLOOR PLAN**  
**SCALE: 1/8" = 1'-0"**  
**TOTAL GROSS SQ FOOTAGE: 37549 SQFT.**  
**1ST FLOOR: 17767 SQFT.**  
**2ND FLOOR: 19782 SQFT.**

Architect's Name ALAN STILTS, Architectural Registration No.24363  
 This document is for interim review only  
 Not for Regulatory approval, permitting, or construction